



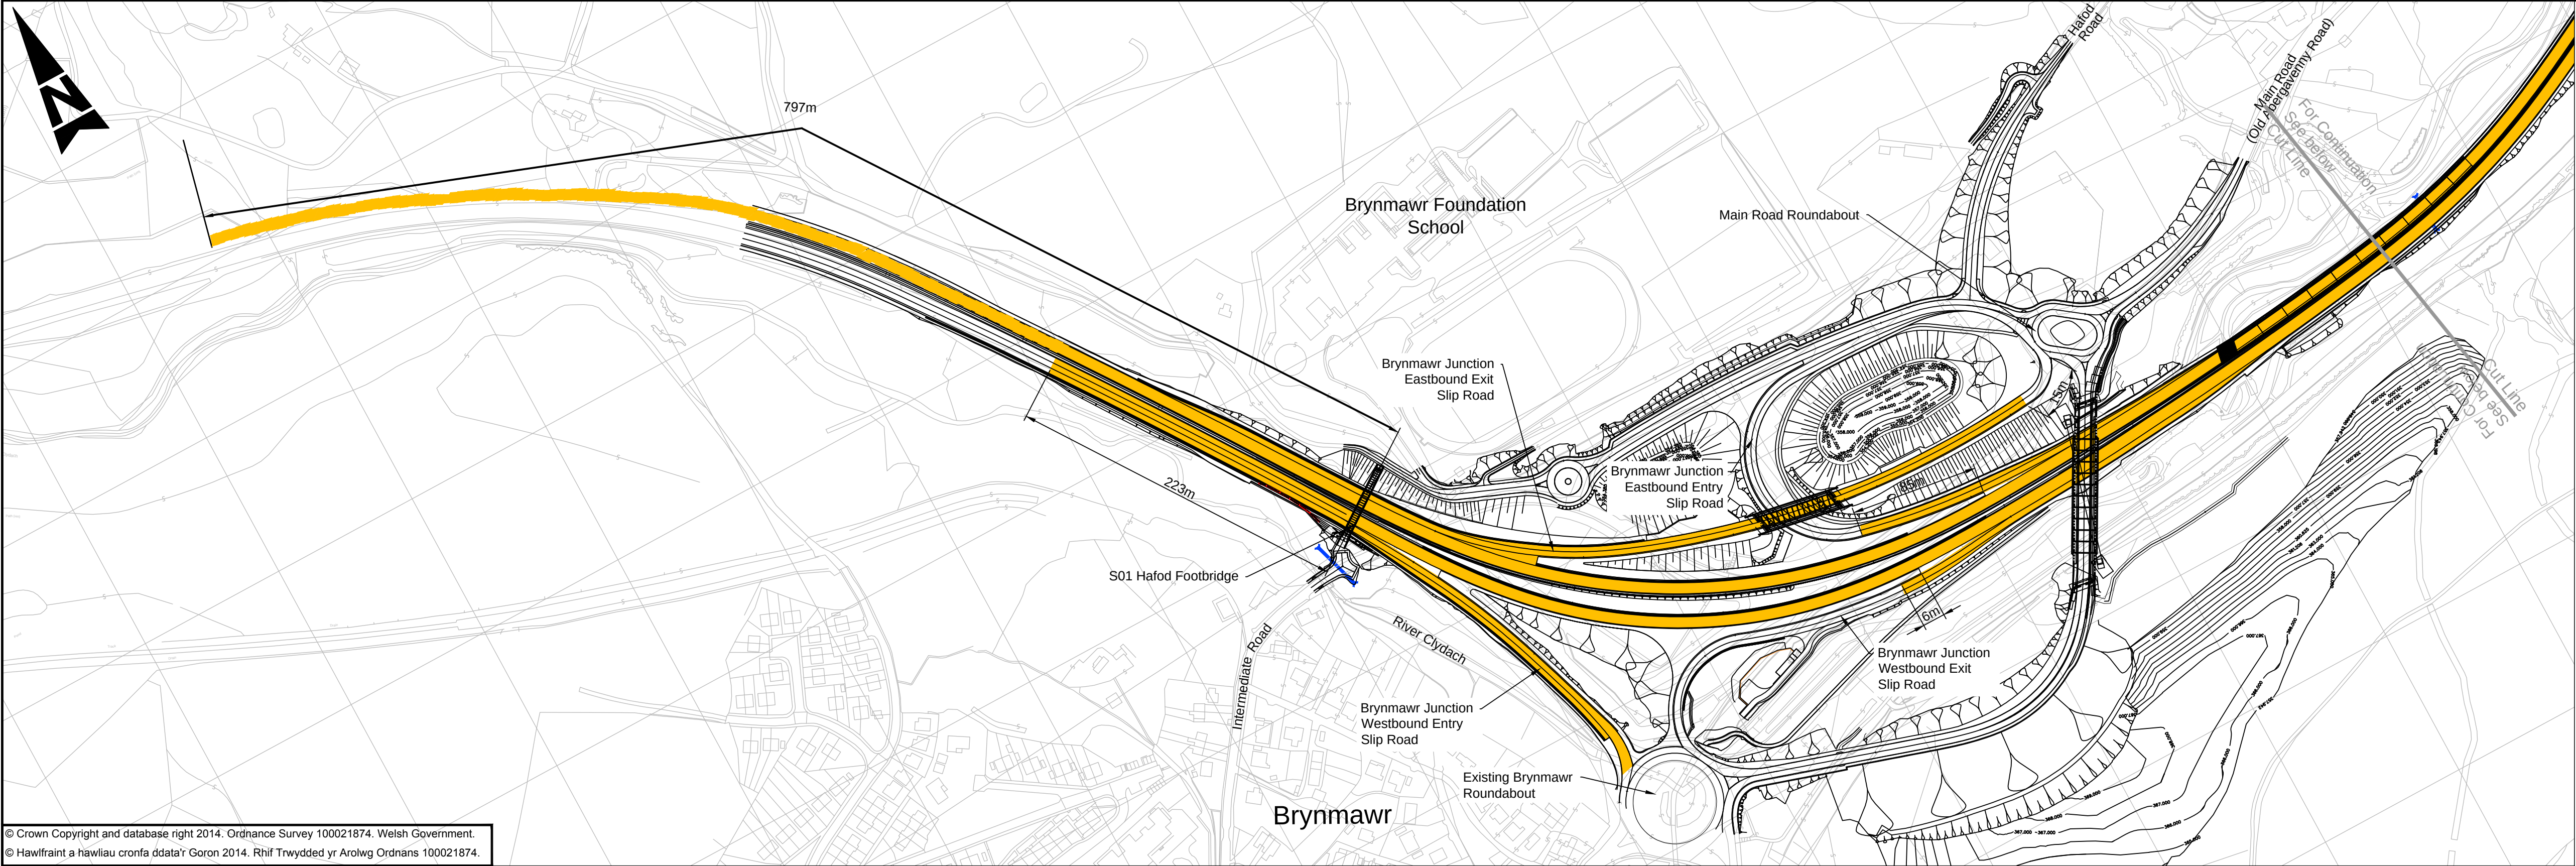


© Crown Copyright and database right 2014. Ordnance Survey 100021874. Welsh Government.
© Hawlfraint a hawliau cronfa ddata'r Goron 2014. Rhif Trwydded yr Arolwg Ordians 100021874.

- NOTES:
- To be read in conjunction with Document No. A465HOV2-CH2-HAC-01_ML-DO-D-0025.
- LEGEND:
- 50 mph speed limit extents

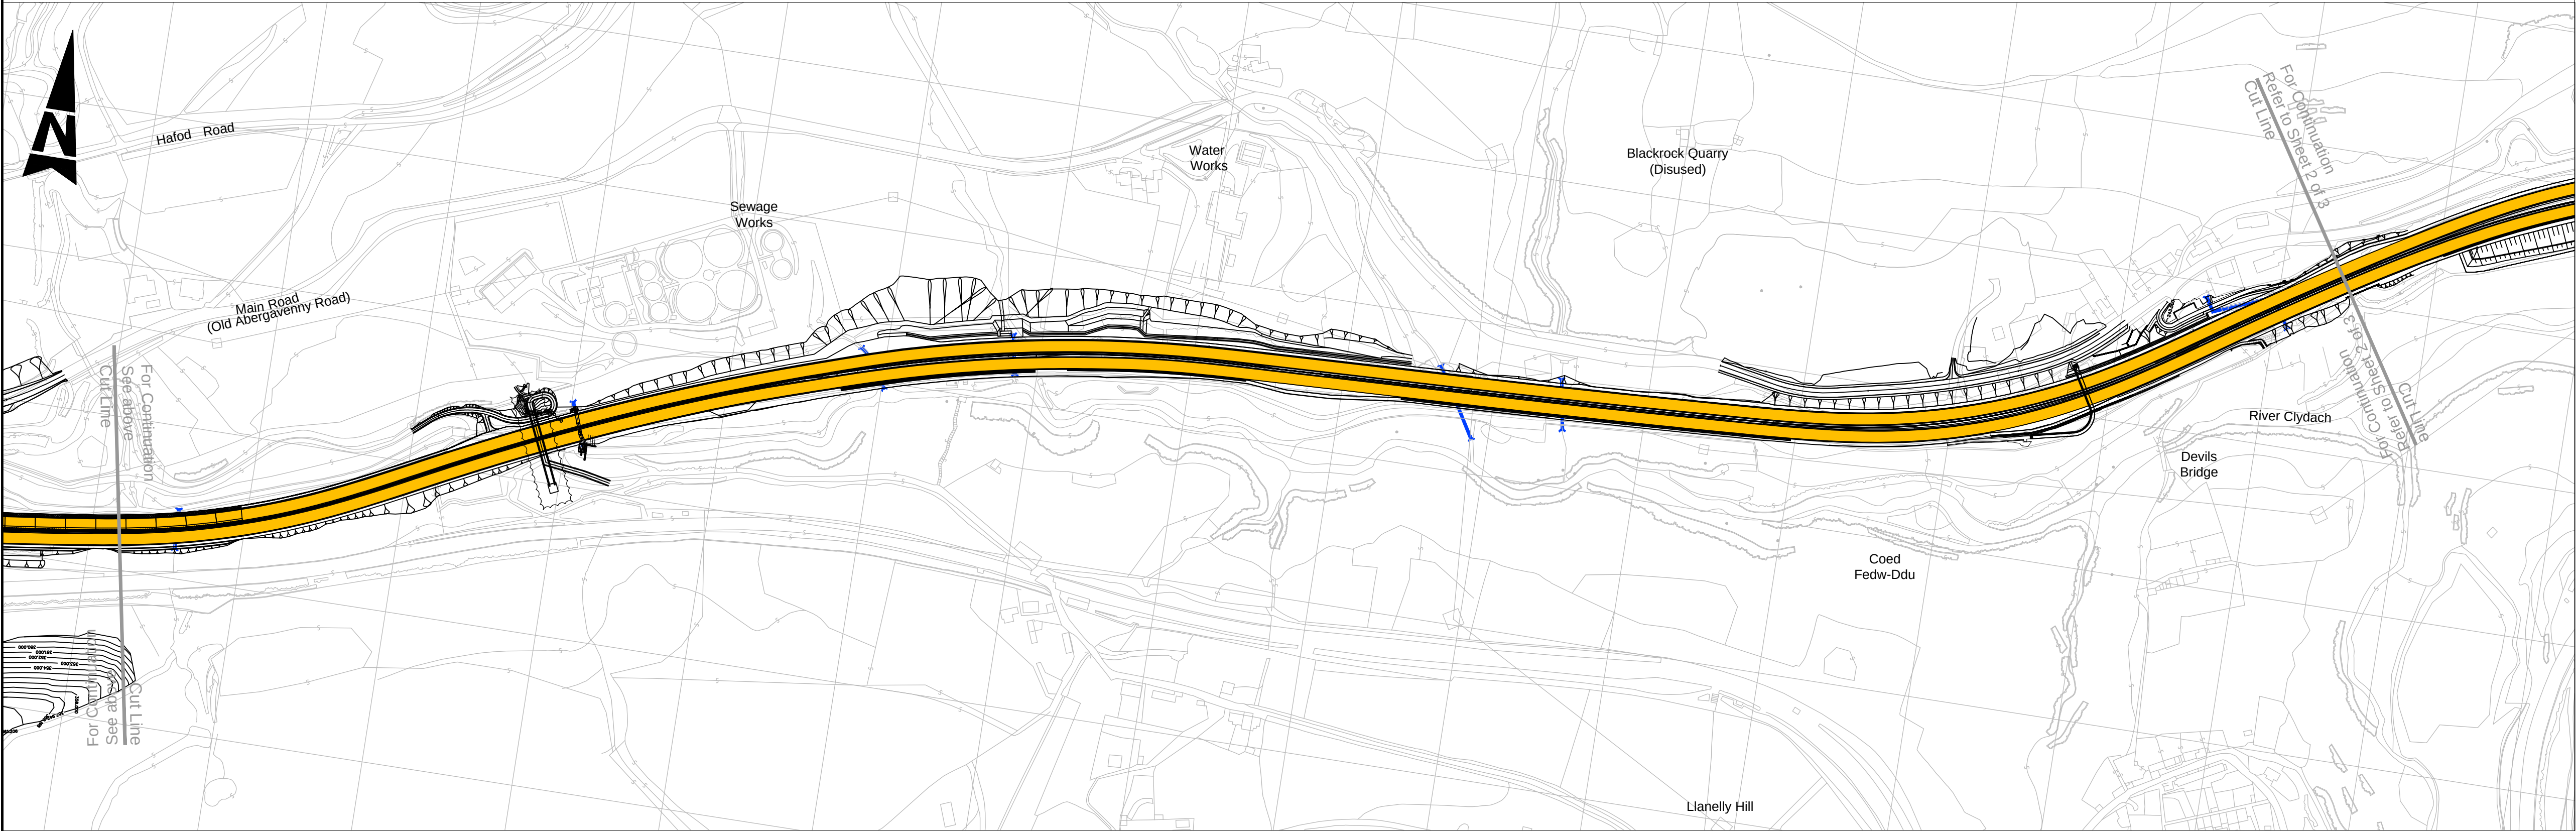

PLAN
Scale 1:2500

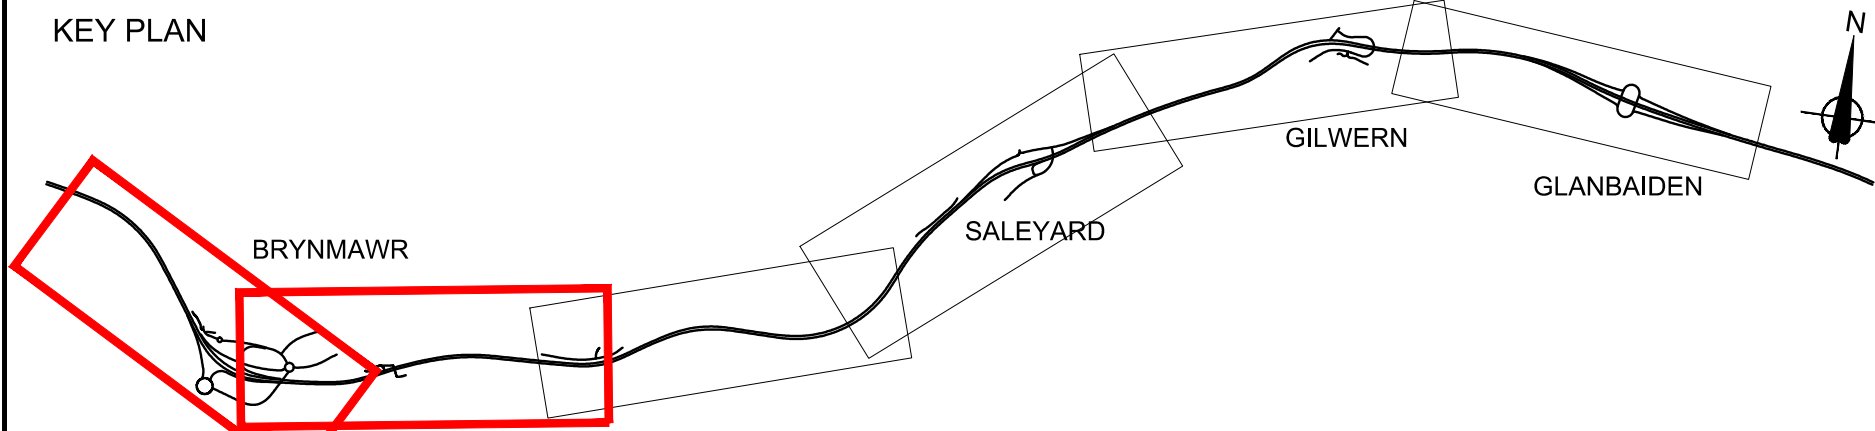

Mark up	Amended extent of 50mph	WW	07/06/21						
P01	For information	LG	23/05/19	HA	SR				
Rev	Description	By	Date	Chk'd	App				




Drawing Status
FOR INFORMATION

Suitability
S2


Drawing Title	PERMANENT TRAFFIC RESTRICTIONS IMPOSITION OF 50MPH SPEED LIMIT SHEET 1 OF 3				
Scale	1:2500	Designed / Drawn	Checked	Approved	Authorised
		LG	HA	SR	PS
Original Size	A1	Date	Date	Date	Date
		22/05/19	22/05/19	22/05/19	23/05/19
Drawing number	A465HOV2-CH2-HAC-01_ML-DR-D-0001				Revision
					Mark up

100
0 10
Millimetres
DO NOT SCALE

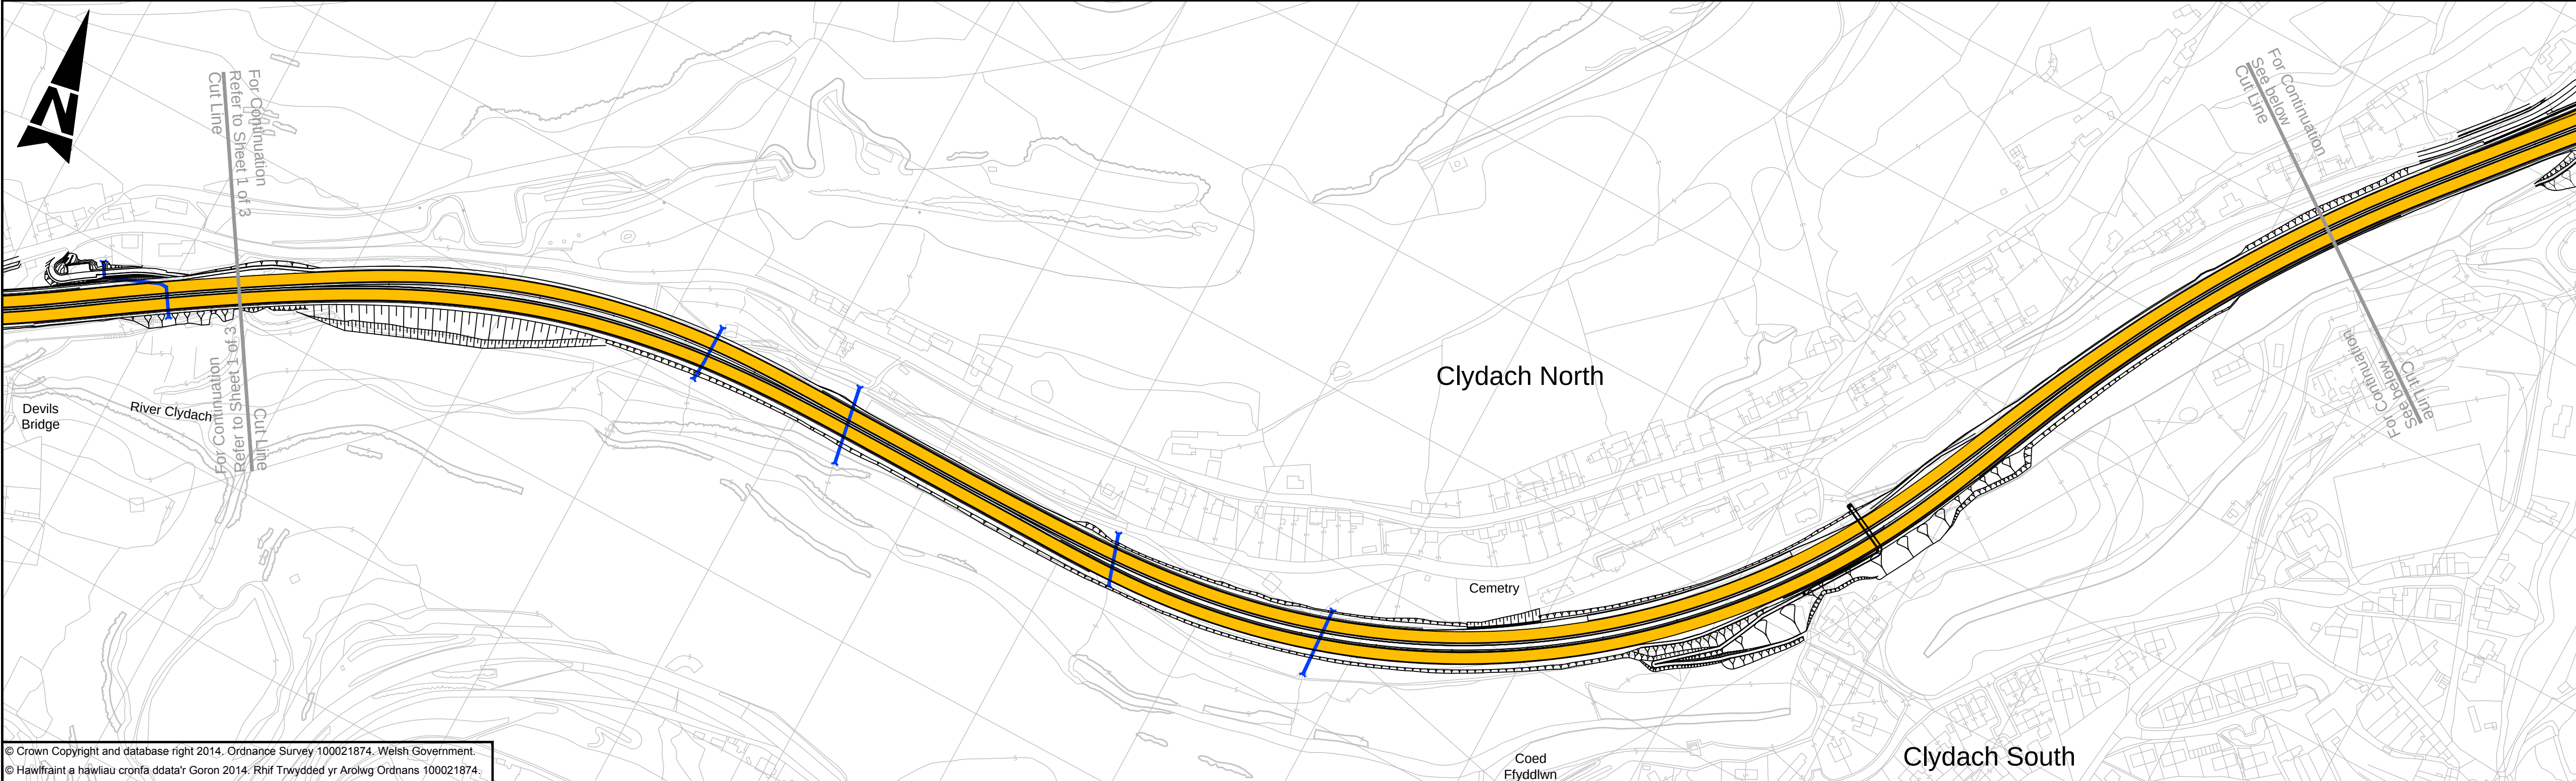

© Crown Copyright and database right 2014. Ordnance Survey 100021874. Welsh Government.
© Hawffraint a hawliau cronfa ddata'r Goron 2014. Rhif Trwydded yr Arolwg Ordnans 100021874.

PLAN
Scale 1:2500

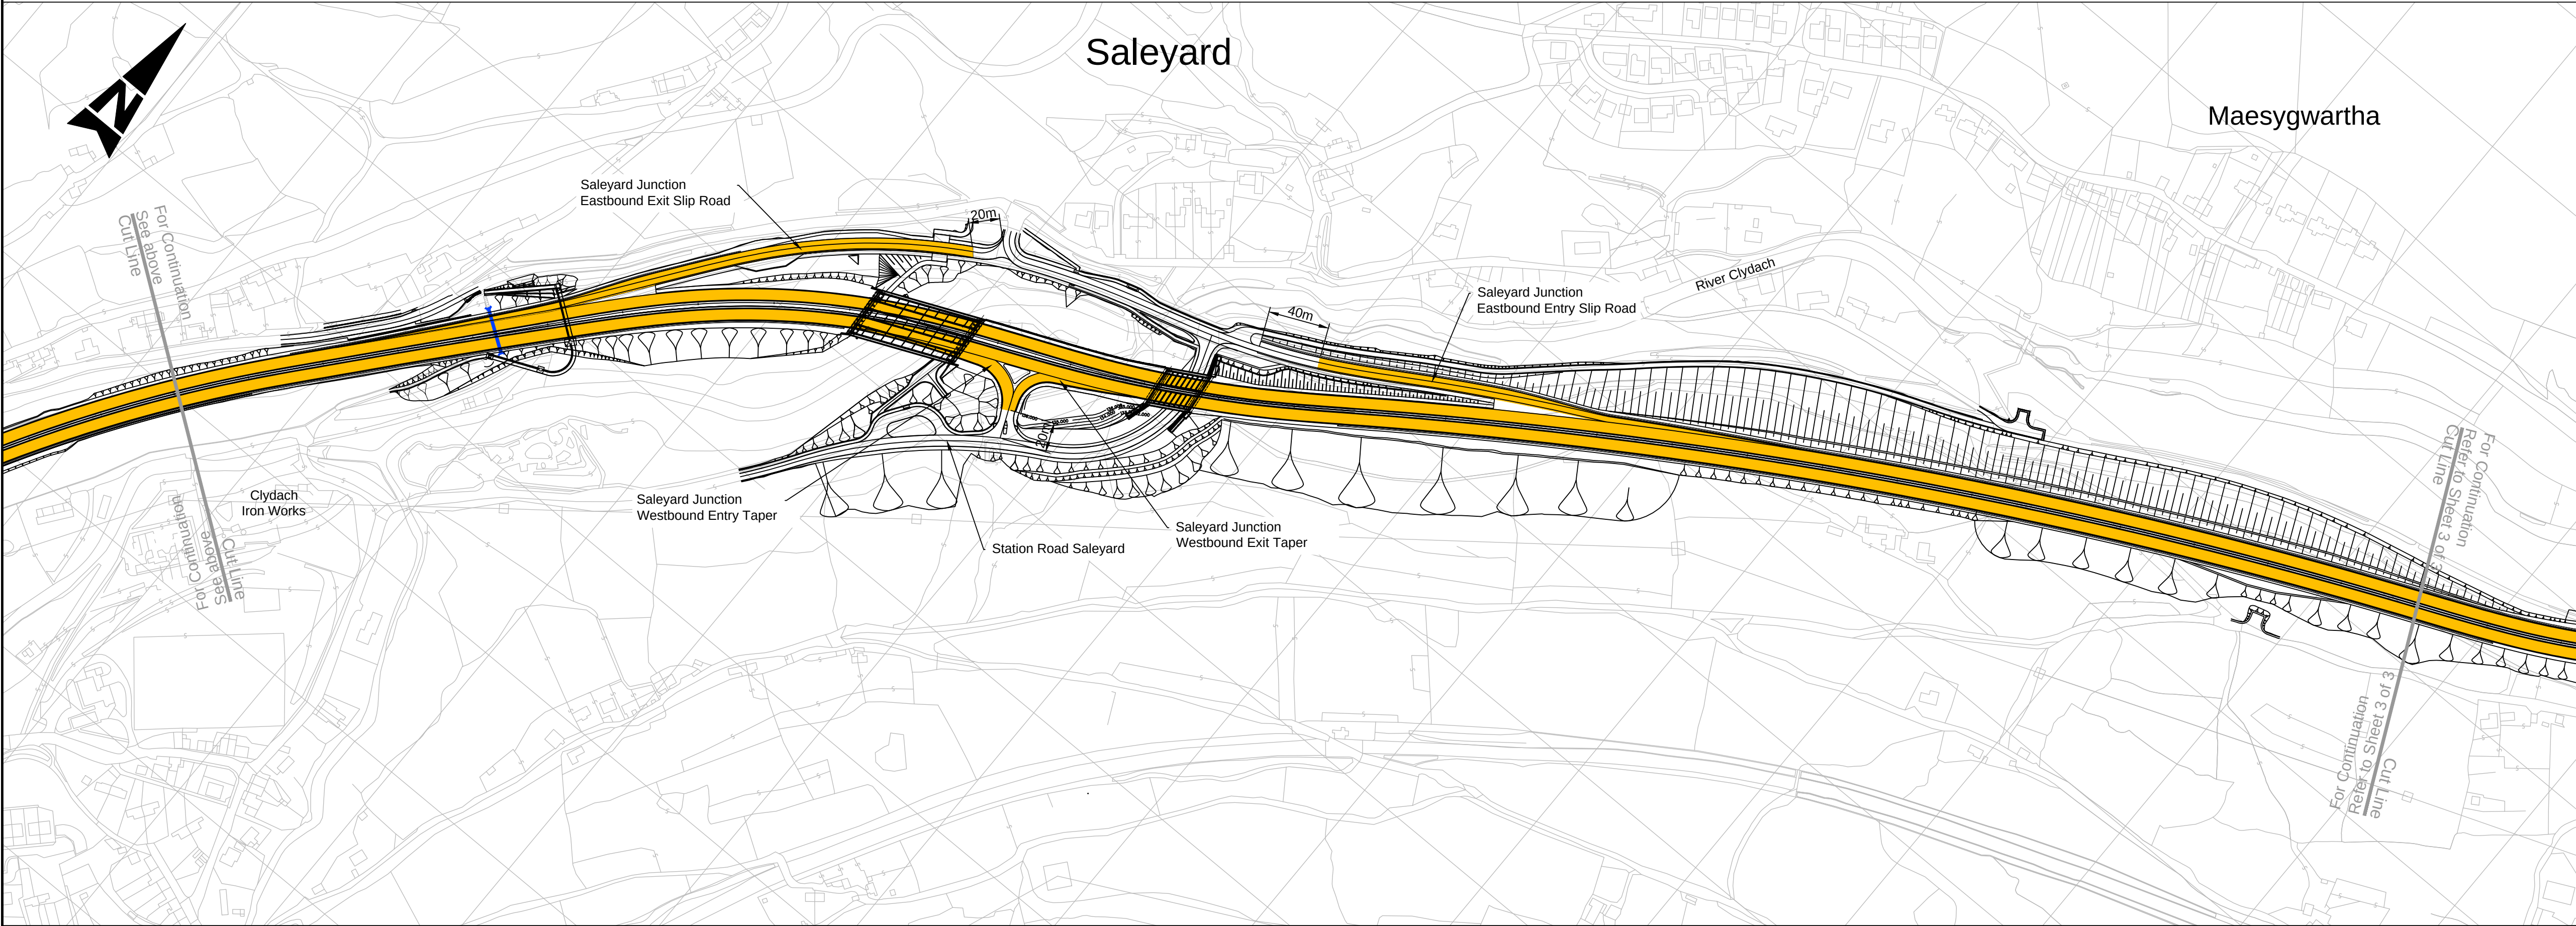


PLAN
Scale 1:2500

NOTES:
1. To be read in conjunction with Document No. A465HOV2-CH2-HAC-01_ML-DO-D-0025.

LEGEND:
50 mph speed limit extents

Plotted: May 24, 2019 - 3:03pm by: ALBERTO H

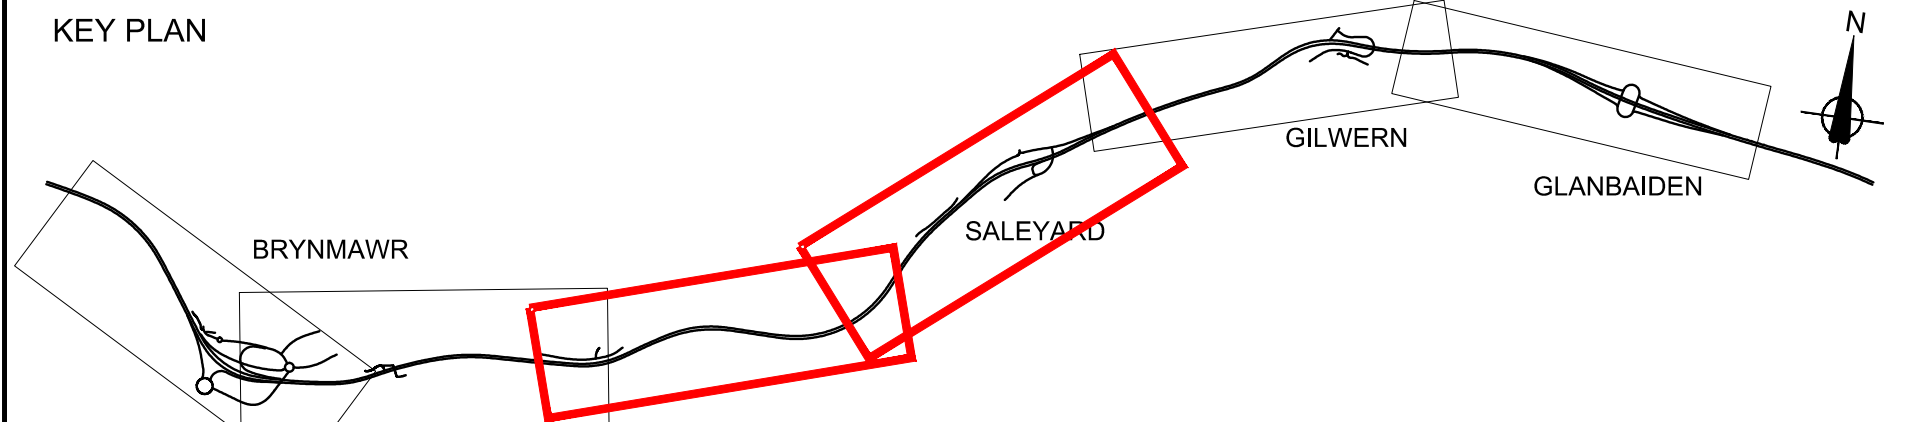

P01	For information	LG	23/05/19	HA	SR				
Rev	Description	By	Date	Chk'd	App				



Llywodraeth Cymru
Welsh Government



ch2m ATKINS
RPS



COSTAIN



A465 Heads of the Valleys
Section 2: Gilwern - Brynmawr

Drawing Status

FOR INFORMATION

Suitability


S2

Drawing Title

PERMANENT TRAFFIC RESTRICTIONS
IMPOSITION OF 50MPH SPEED LIMIT
SHEET 2 OF 3


Scale	1:2500	Designed / Drawn	LG	Checked	HA	Approved	SR	Authorised	PS	
Original Size	A1	Date	22/05/19	Date	22/05/19	Date	22/05/19	Date	23/05/19	
Drawing number	A465HOV2-CH2-HAC-01_ML-DR-D-0002								Revision	P01

100
10
0
DO NOT SCALE
Millimetres

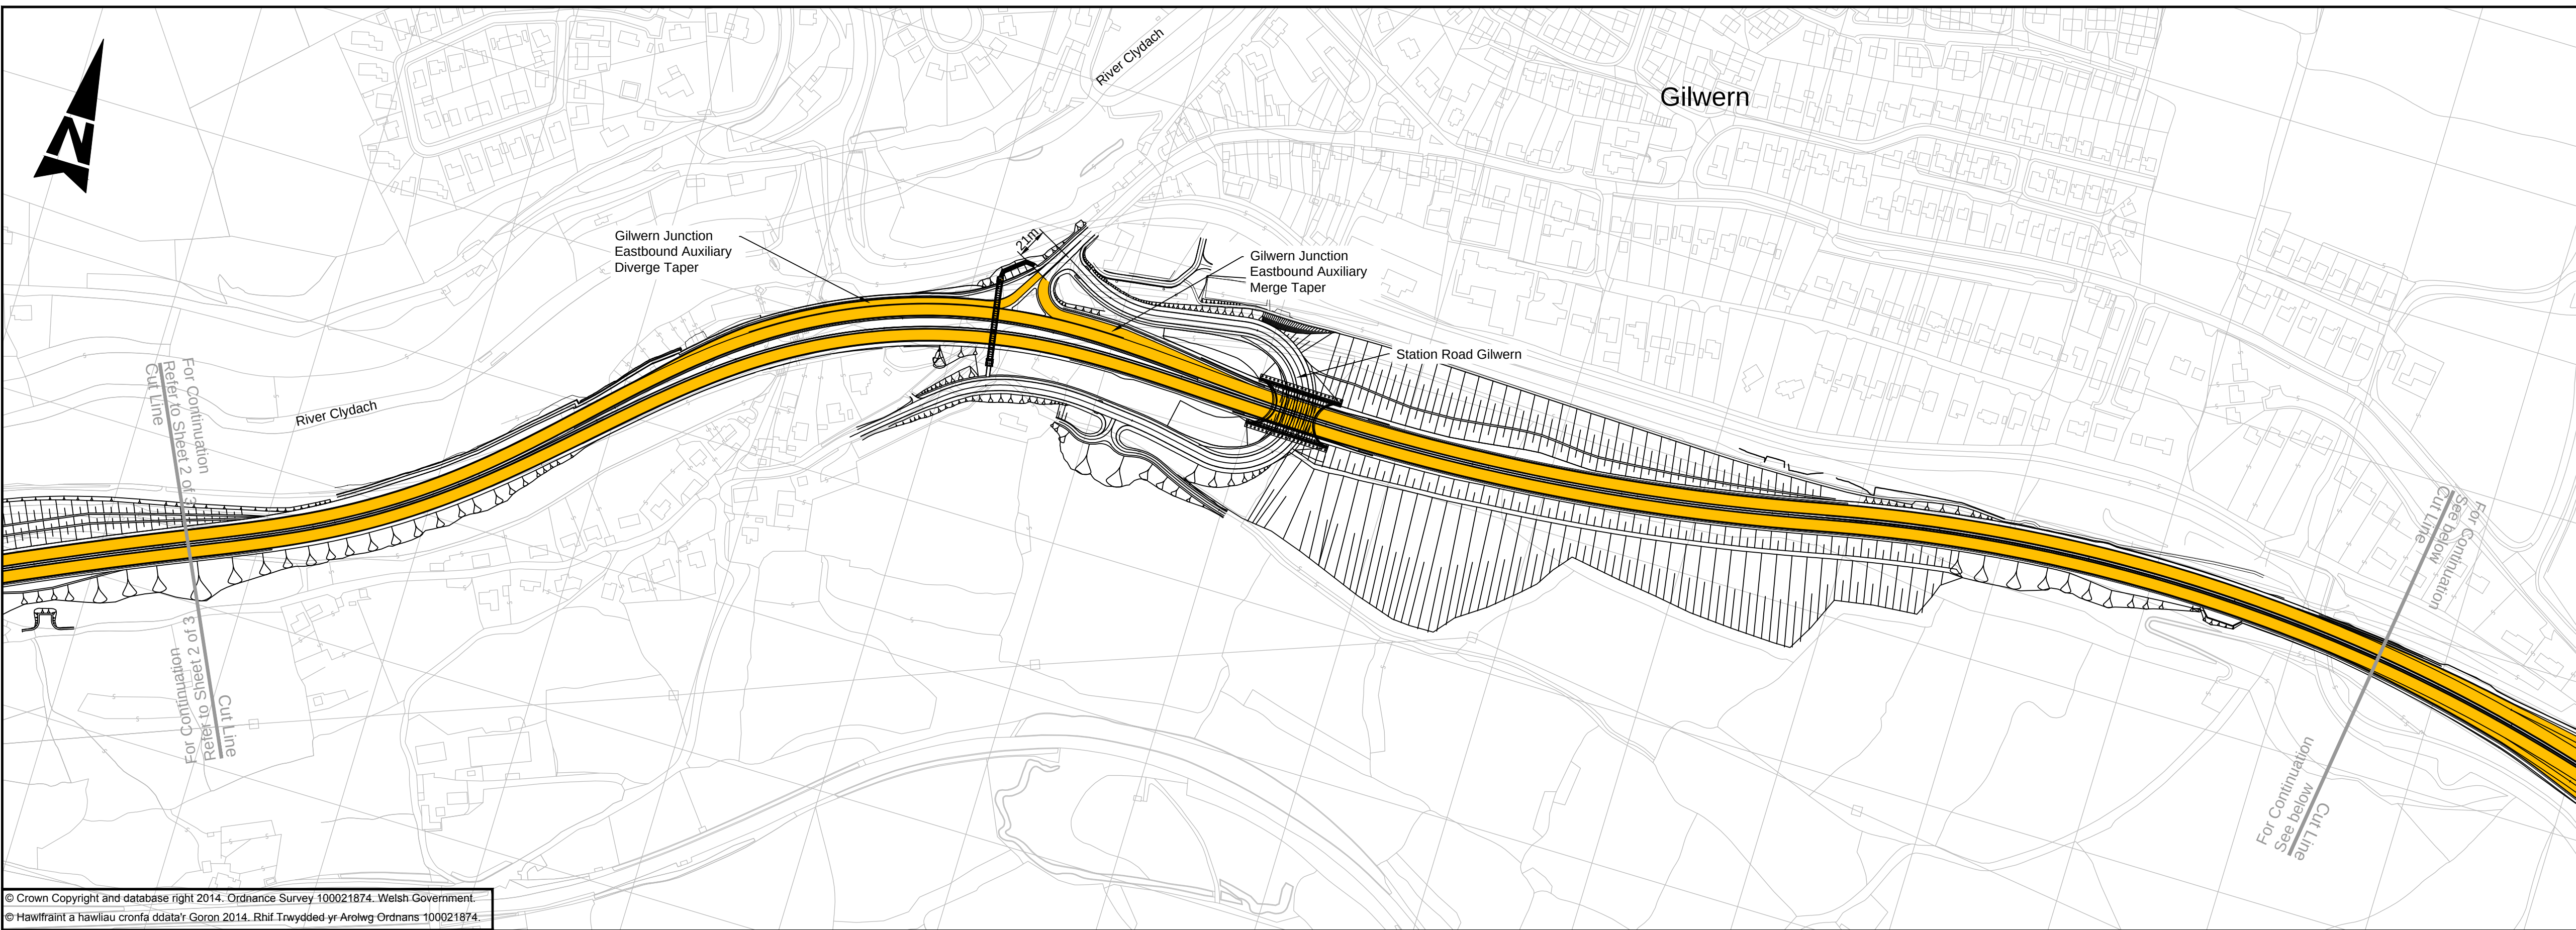


© Crown Copyright and database right 2014. Ordnance Survey 100021874. Welsh Government.
© Hawlfraint a hawliau cronfa ddata'r Goron 2014. Rhif Trwydded yr Arolwg Ordnans 100021874.


PLAN
Scale 1:2500

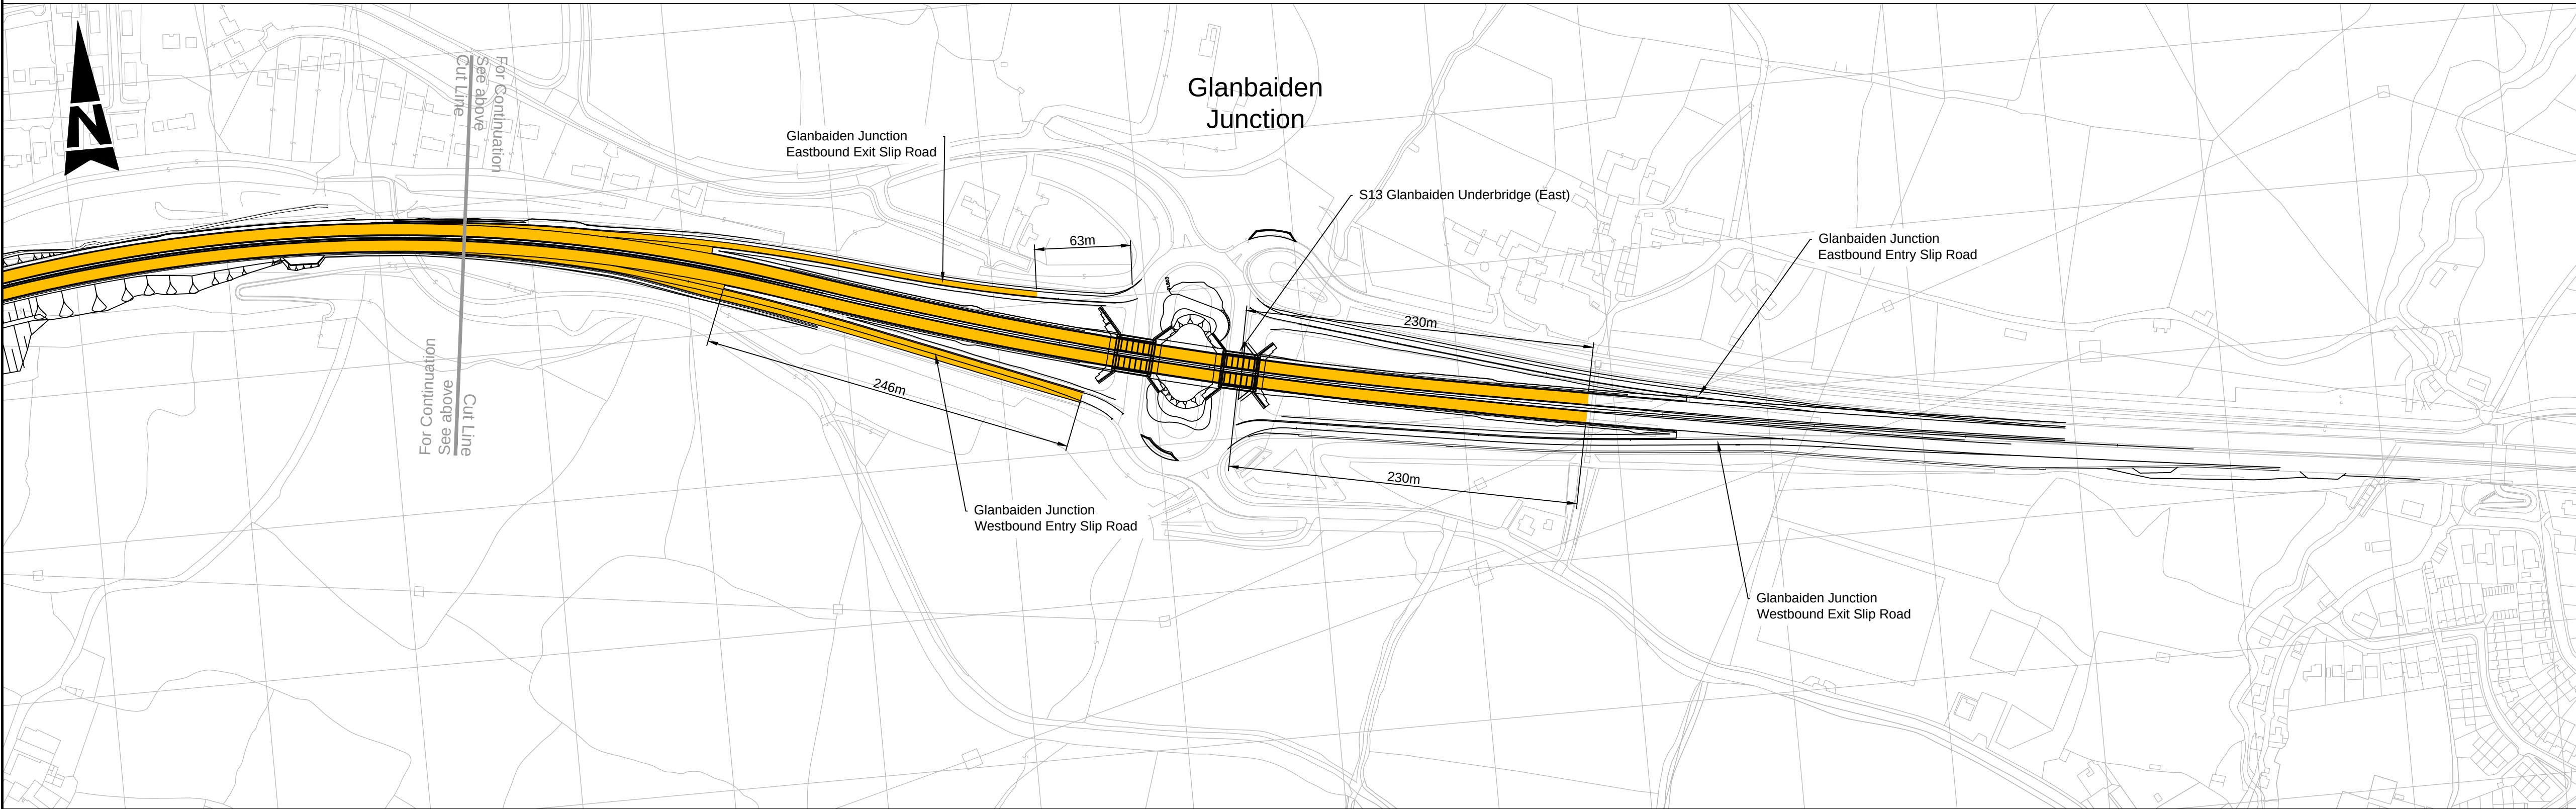

PLAN
Scale 1:2500

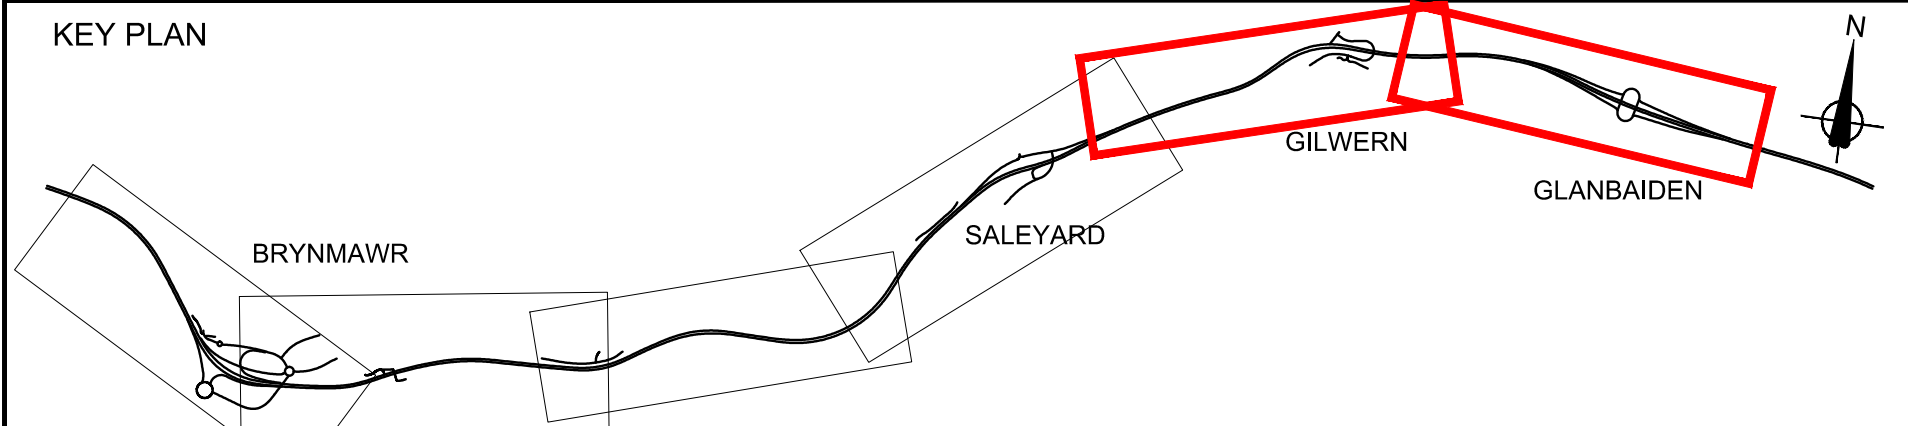

P01	For information	LG	23/05/19	HA	SR
Rev	Description	By	Date	Chk'd	App

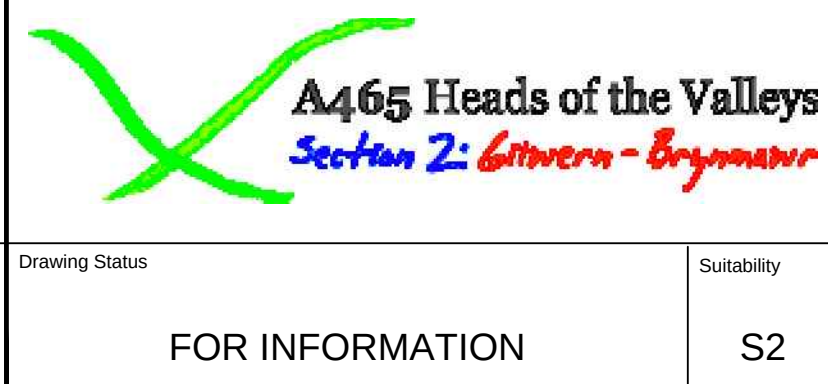

- NOTES:
- To be read in conjunction with Document No. A465HOV2-CH2-HAC-01_ML-D-0-0025.
- LEGEND:
- 50 mph speed limit extents

Drawing Title	PERMANENT TRAFFIC RESTRICTIONS IMPOSITION OF 50MPH SPEED LIMIT SHEET 3 OF 3				
Scale	1:2500	Designed / Drawn	Checked	Approved	Authorised
		LG	HA	SR	PS
Original Size	A1	Date	Date	Date	Date
		22/05/19	22/05/19	22/05/19	23/05/19
Drawing number					Revision
A465HOV2-CH2-HAC-01_ML-DR-D-0003					P01