100
Millimetres
0 10
DO NOT SCALE

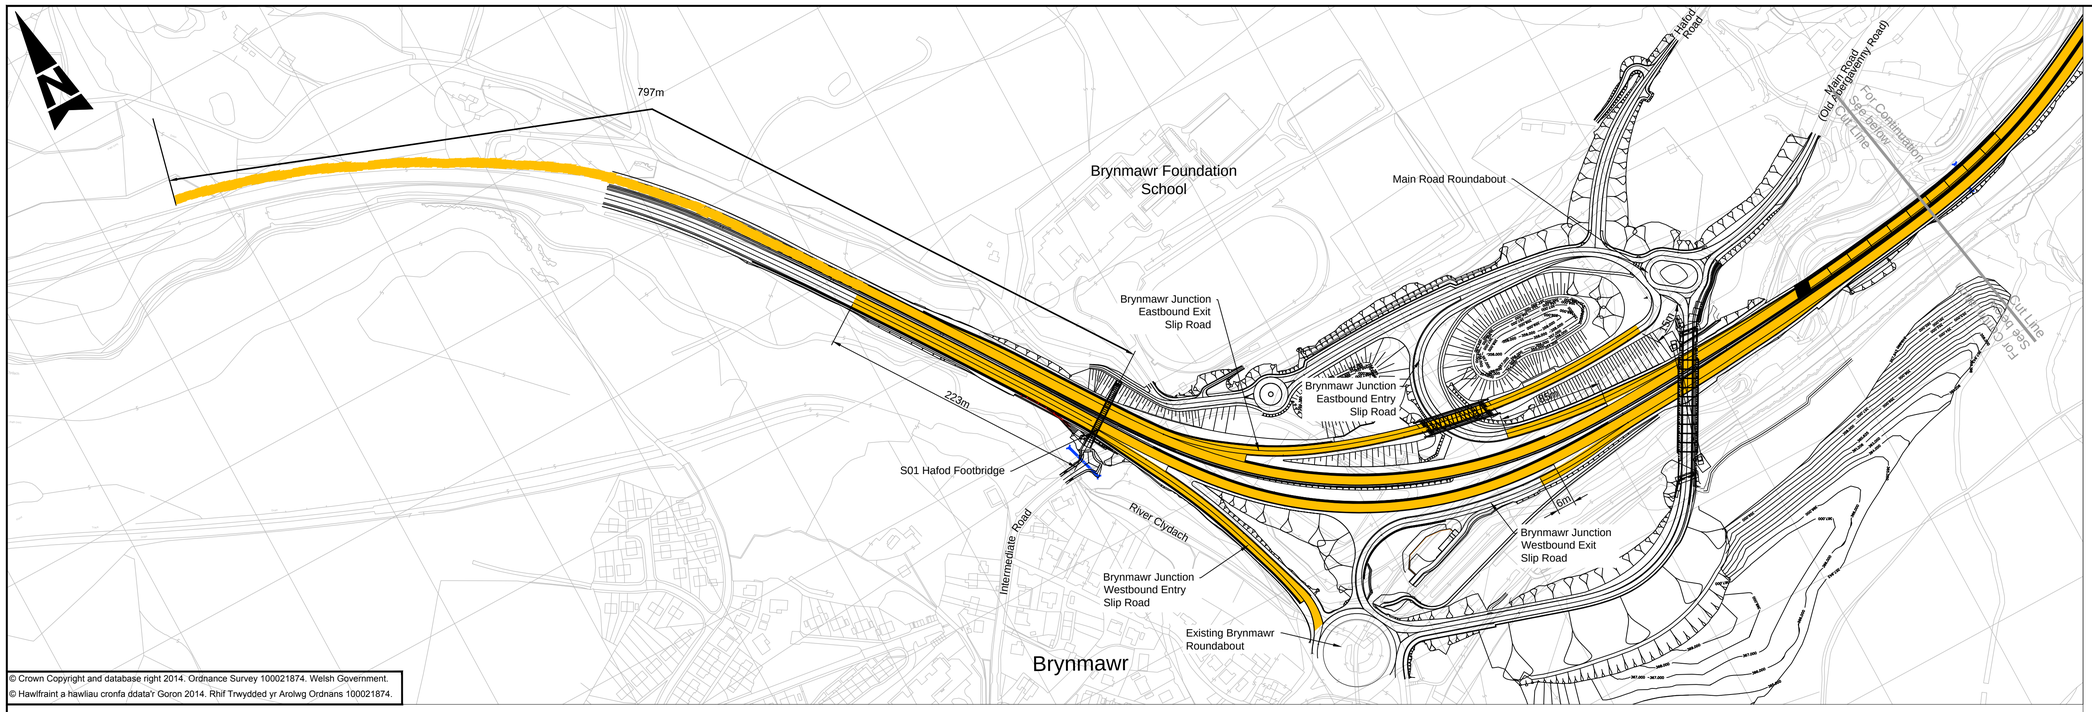

© Crown Copyright and database right 2014. Ordnance Survey 100021874. Welsh Government.
© Hawlfraint a hawliau cronfa ddata'r Goron 2014. Rhif Trwydded yr Arolwg Ordnans 100021874.

PLAN
Scale 1:2500

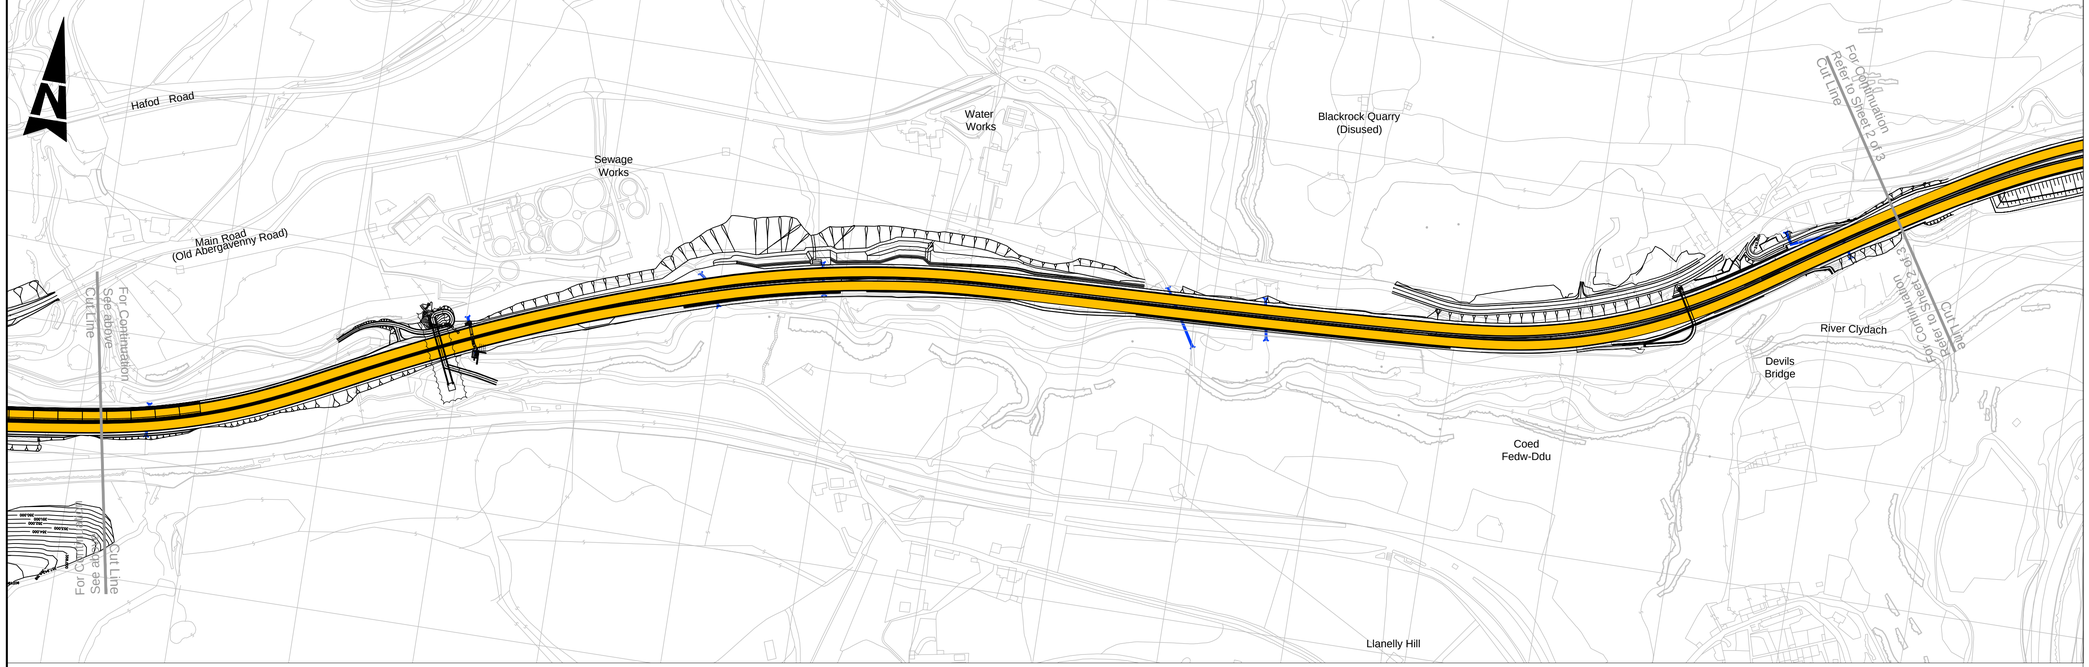

PLAN
Scale 1:2500

KEY PLAN

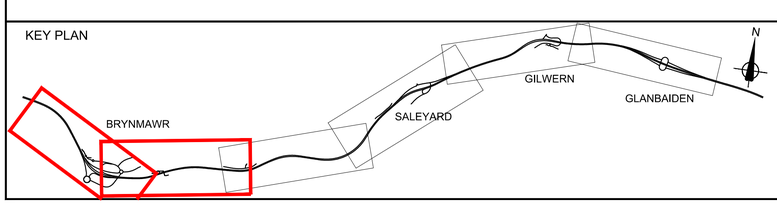

Rev	Description	By	Date	Chk'd	App
Mark up	Amended extent of 50mph	WW	07/06/21		
P01	For information	LG	23/05/19	HA	SR

Llywodraeth Cymru
Welsh Government

ch2m: ATKINS
RPS
COSTAIN

A465 Heads of the Valleys
Section 2: Gilwern - Brynmawr

NOTES:

1. To be read in conjunction with Document No. A465HOV2-CH2-HAC-01_ML-DO-D-0025.

LEGEND:

50 mph speed limit extents

Drawing Title: PERMANENT TRAFFIC RESTRICTIONS IMPOSITION OF 50MPH SPEED LIMIT SHEET 1 OF 3

Scale	Designed / Drawn	Checked	Approved	Authorised
1:2500	LG	HA	SR	PS
Original Size: A1	Date: 22/05/19	Date: 22/05/19	Date: 22/05/19	Date: 23/05/19

Drawing Status: FOR INFORMATION
Suitability: S2
Drawing number: A465HOV2-CH2-HAC-01_ML-DR-D-0001
Revision: Mark up

Plotted: May 24, 2019 - 3:01pm by: ALBERTOH